

COUNTY OF ST. PAUL NO. 19

BY-LAW NO. 2017-23

A By-law of the County of St. Paul, in the Province of Alberta to change the boundaries of an environmental reserve to rectify an encroachment problem or other concern within Lot R, Block 1, Plan 527MC registered in respect of Part of SW 17-59-9-W4 located within the boundaries of the County of St. Paul.

WHEREAS, Section 676(1)(d) of the Municipal Government Act, as amended, provides that a Council may change the boundaries of an environmental reserve or environmental reserve easement in order to correct an omission, error or other defect in the certificate of title, or to rectify an encroachment problem or other concern.

AND WHEREAS the public hearing and public hearing notification requirements of Sections 230 and 606 of the Municipal Government Act., as amended, for a Bylaw considering pursuant to Section 676 have been complied with:

NOW, THEREFORE the Council of the County of St. Paul No. 19, hereby assembled, enacts the following:

That the portion of the Environmental Reserve designation of Lot R, Block 1, Plan 527MC displayed on the attached plan forming part of this Bylaw is hereby cancelled.

Read a first time in Council this 12th day of December A.D. 2017.

Advertised the 28th day of November, A.D.2017, and the 5th day of December, A.D. 2017 in the St. Paul Journal.

Read a second time in Council this 12th day of December A.D. 2017.


Read a third time in Council this 12th day of December A.D. 2017.

(Original signed by Reeve S. Upham)

(Original signed by CAO S. Kitz)

Reeve

Chief Administrative Officer

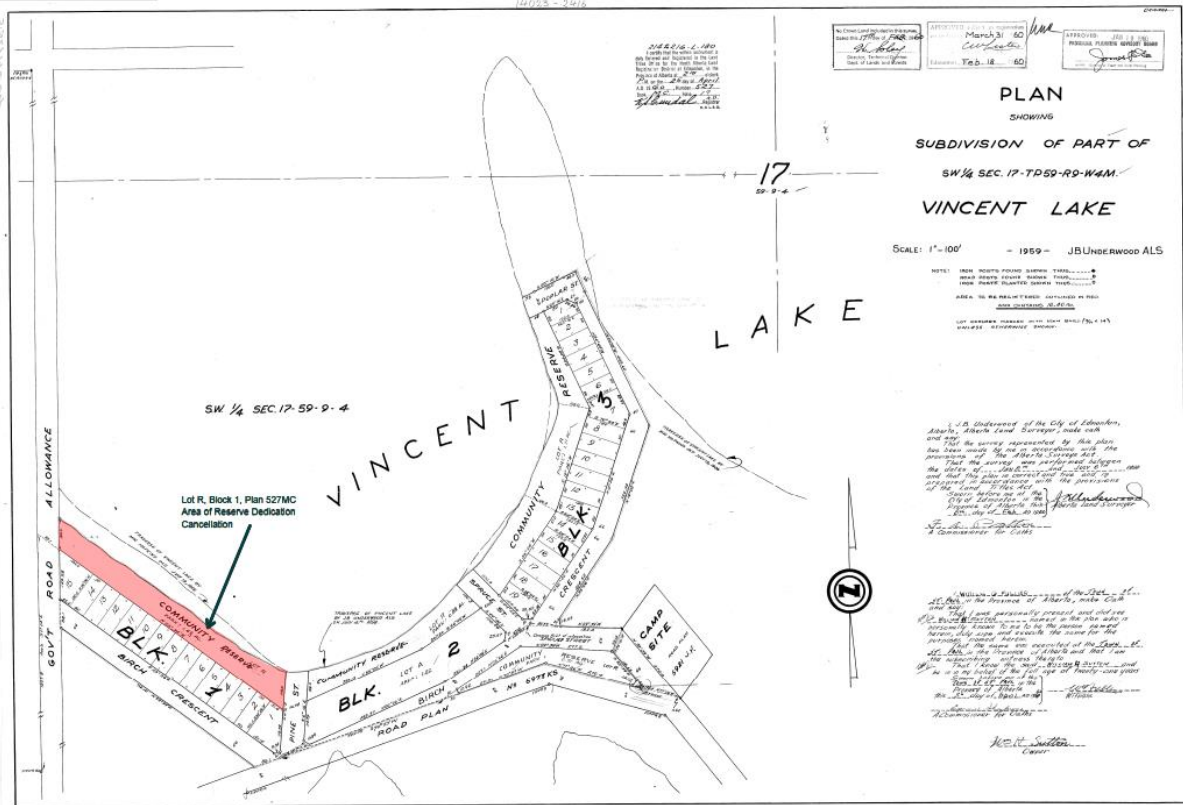

105220 1-100
 105220 1-100
APPROVED FOR THE CITY OF
 EDWARDSVILLE, ILLINOIS
 APPROVED FOR THE CITY OF
 EDWARDSVILLE, ILLINOIS
 APPROVED FOR THE CITY OF
 EDWARDSVILLE, ILLINOIS

PLAN
 SHOWING
SUBDIVISION OF PART OF
 SW 1/4 SEC. 17-1759-19-WAM.
VINCENT LAKE

SCALE: 1"=100' - 1959 - JB UNDERWOOD ALS

NOTE: AREA SHOWN IN RED IS AREA OF RESERVE DEDICATION CANCELLATION
 AREA TO BE REALLOCATED AS PER PLAN
 AND RESERVE DEDICATION

I, J.B. Underwood, of the City of Edwardsville, Illinois, hereby certify that the plan shown hereon is a true and correct copy of the original plan as shown to me and that the same is a true and correct copy of the original plan as shown to me and that the same is a true and correct copy of the original plan as shown to me...

I, William A. Sullivan, of the City of Edwardsville, Illinois, hereby certify that the plan shown hereon is a true and correct copy of the original plan as shown to me and that the same is a true and correct copy of the original plan as shown to me...

Wm. A. Sullivan
 Mayor

